



FILE: H:\2013\1310413\1310413-GRADING.DWG
 DATE PLOTTED: 8/26/2014 10:34 AM
 PLOTTED BY: TCM, HODD
 DESIGNED BY: TCM

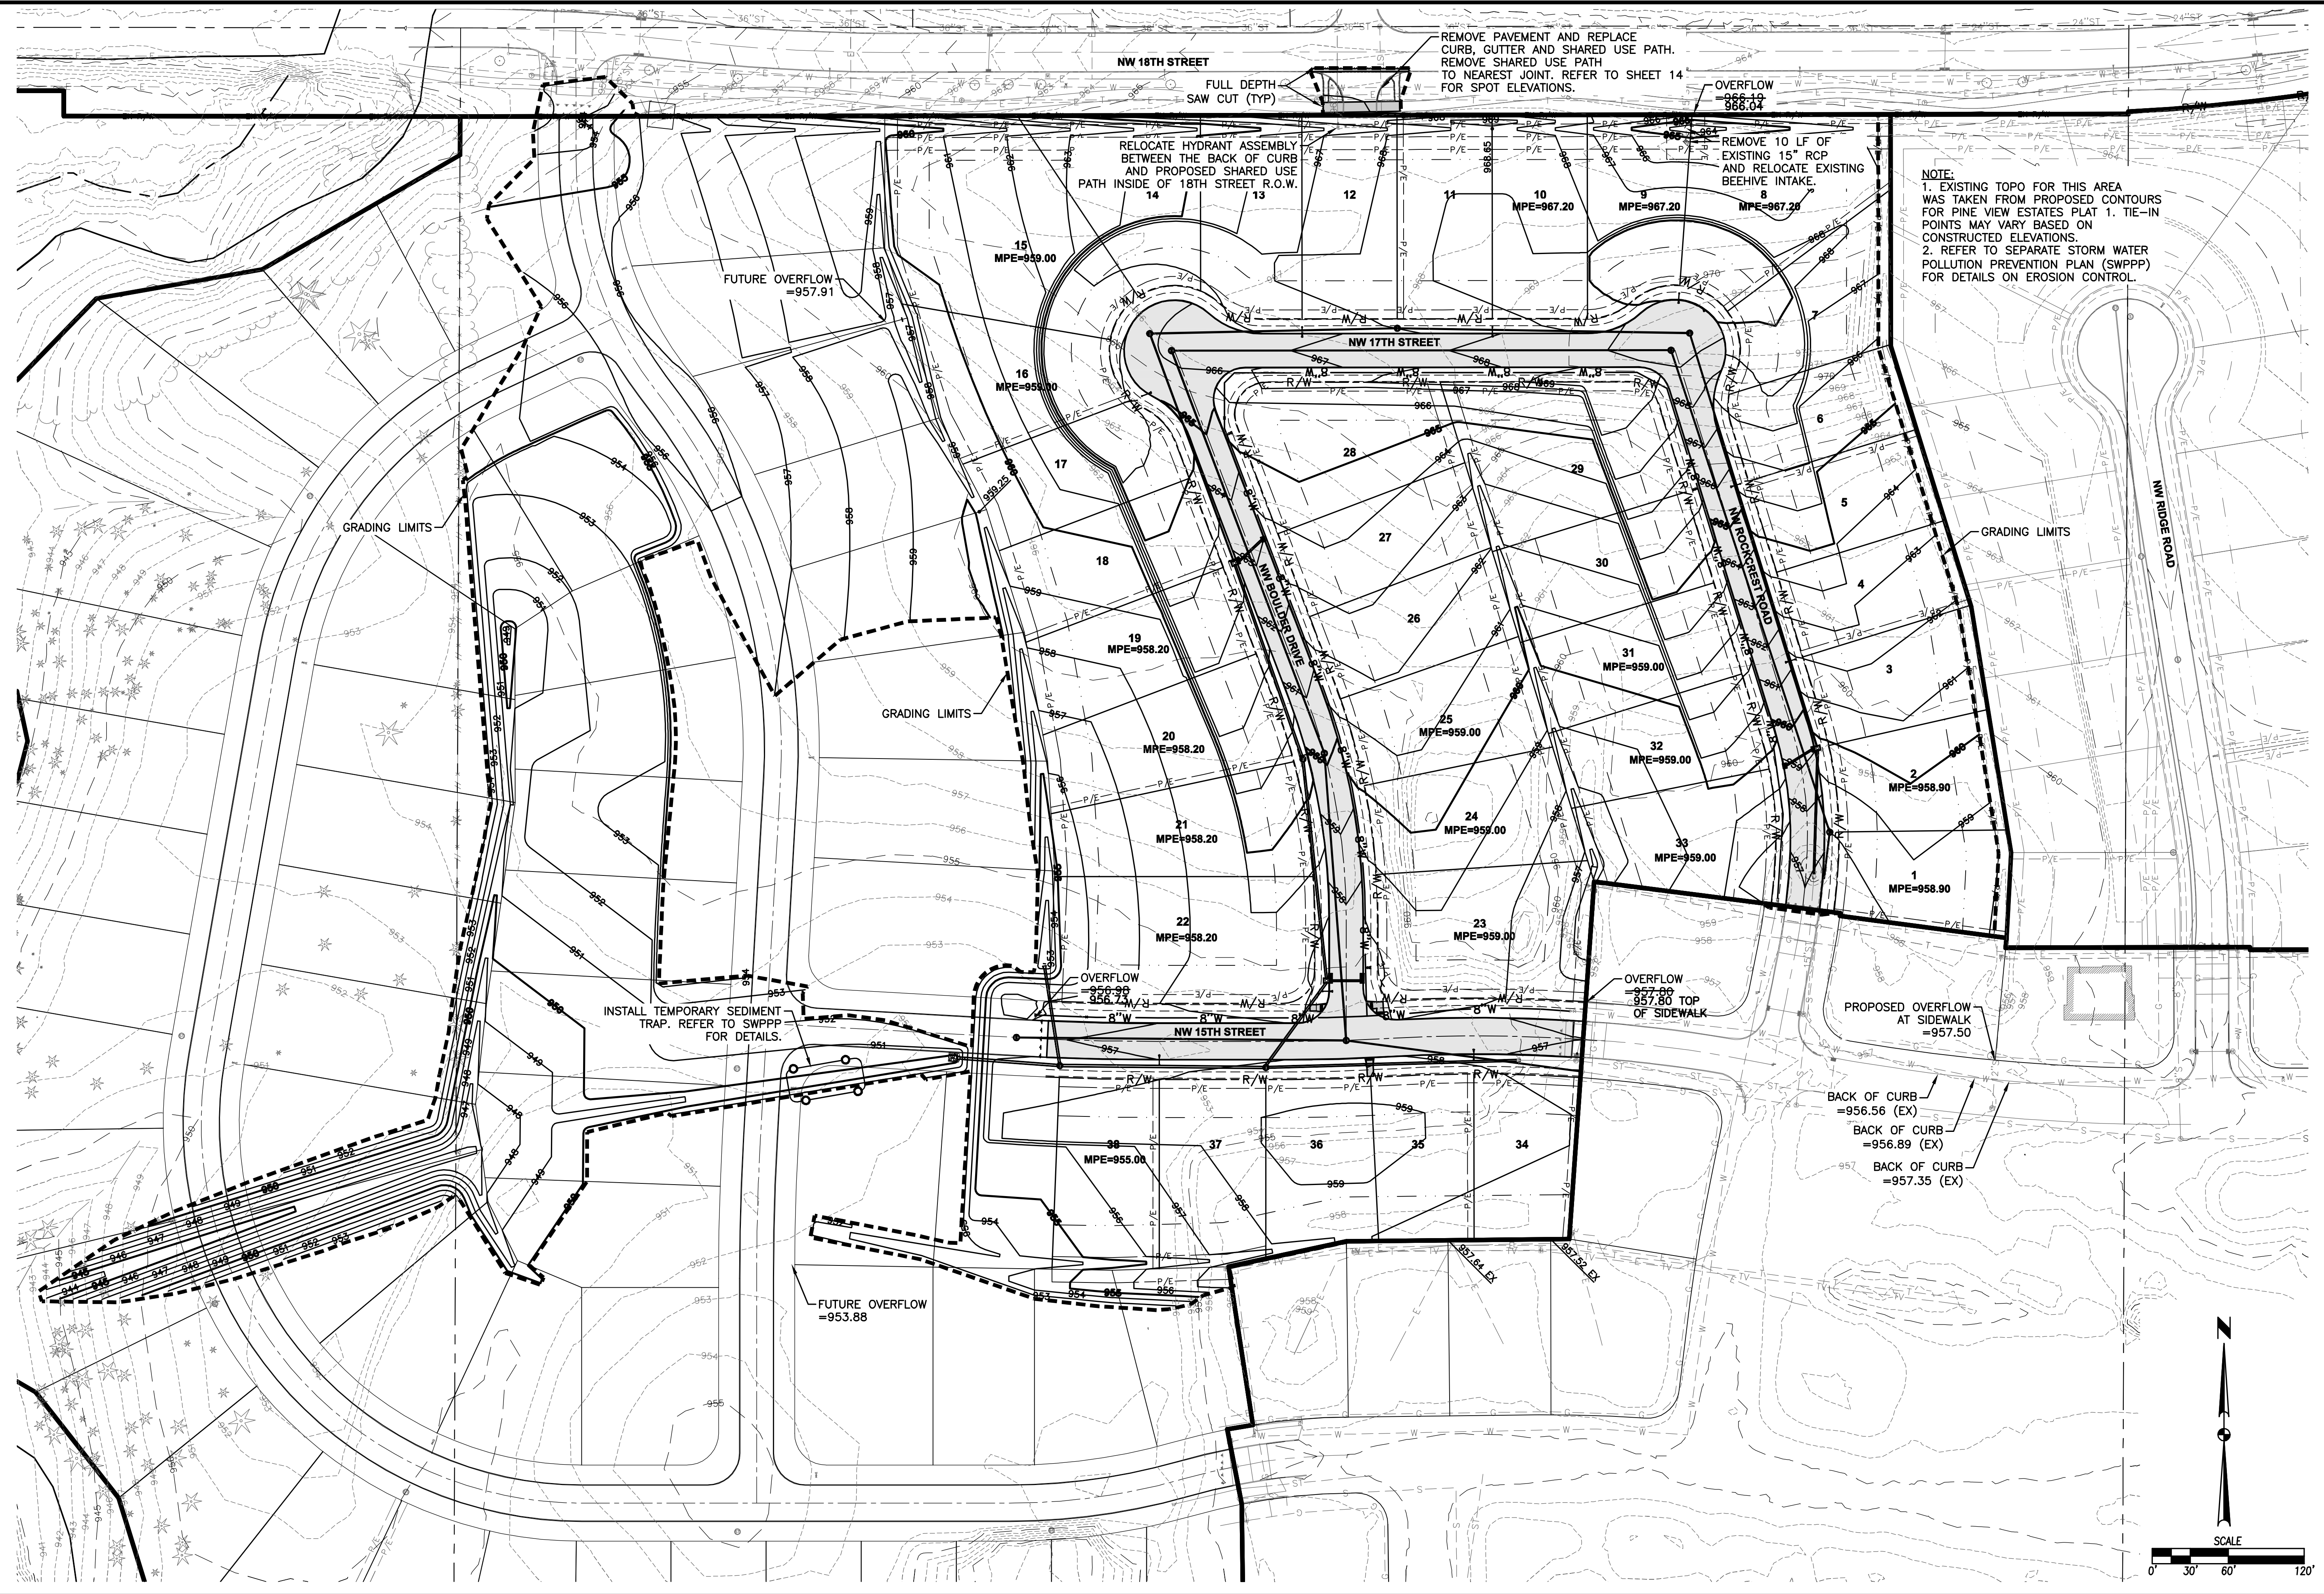


NOTE:
 1. EXISTING TOPO FOR THIS AREA WAS TAKEN FROM PROPOSED CONTOURS FOR PINE VIEW ESTATES PLAT 1. TIE-IN POINTS MAY VARY BASED ON CONSTRUCTED ELEVATIONS.
 2. REFER TO SEPARATE STORM WATER POLLUTION PREVENTION PLAN (SWPPP) FOR DETAILS ON EROSION CONTROL.

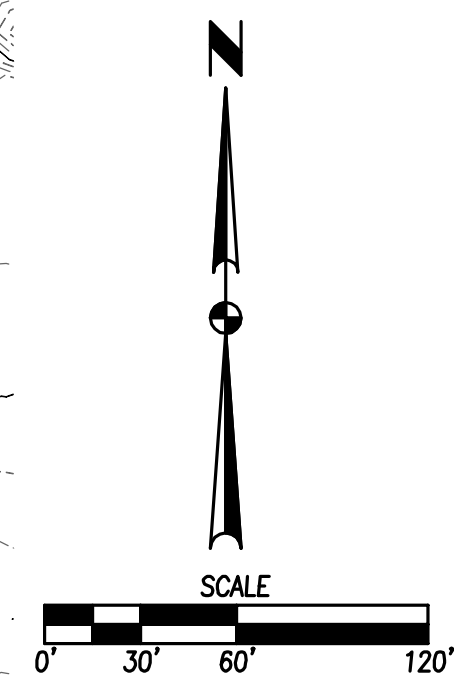

REVISIONS	DATE
AS-BUILT SUBMITTAL	08/26/14
FINAL SUBMITTAL	02/28/14
THIRD SUBMITTAL	01/29/14
SECOND SUBMITTAL	07/10/14
FIRST SUBMITTAL	12/20/13

3405 S.E. CROSSROADS DRIVE, SUITE G
 GRIMES, IOWA 50111
 PHONE: (515) 369-4400 FAX: (515) 369-4410
 ENGINEER: EKO
 EI: JMM

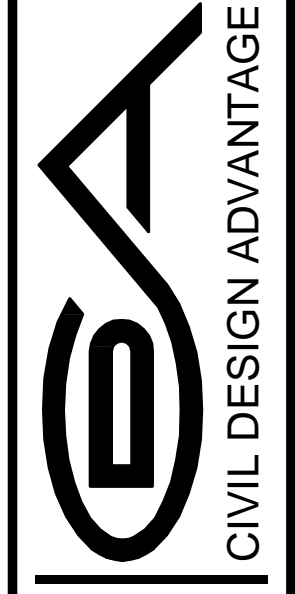

ANKENY, IOWA

PINE VIEW ESTATES PLAT 2

GRADING PLAN