

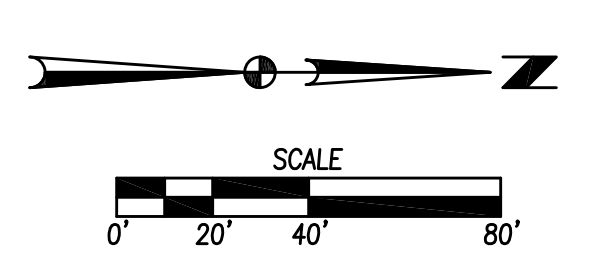


FILE: H:\2015\1512837\DWG\1512837-GRADING.DWG
 COMMENTS: EXC.
 PLOTTED BY: ERIN O'LEWICKI TECH.
 DATE: 9/23/2016 3:24 PM

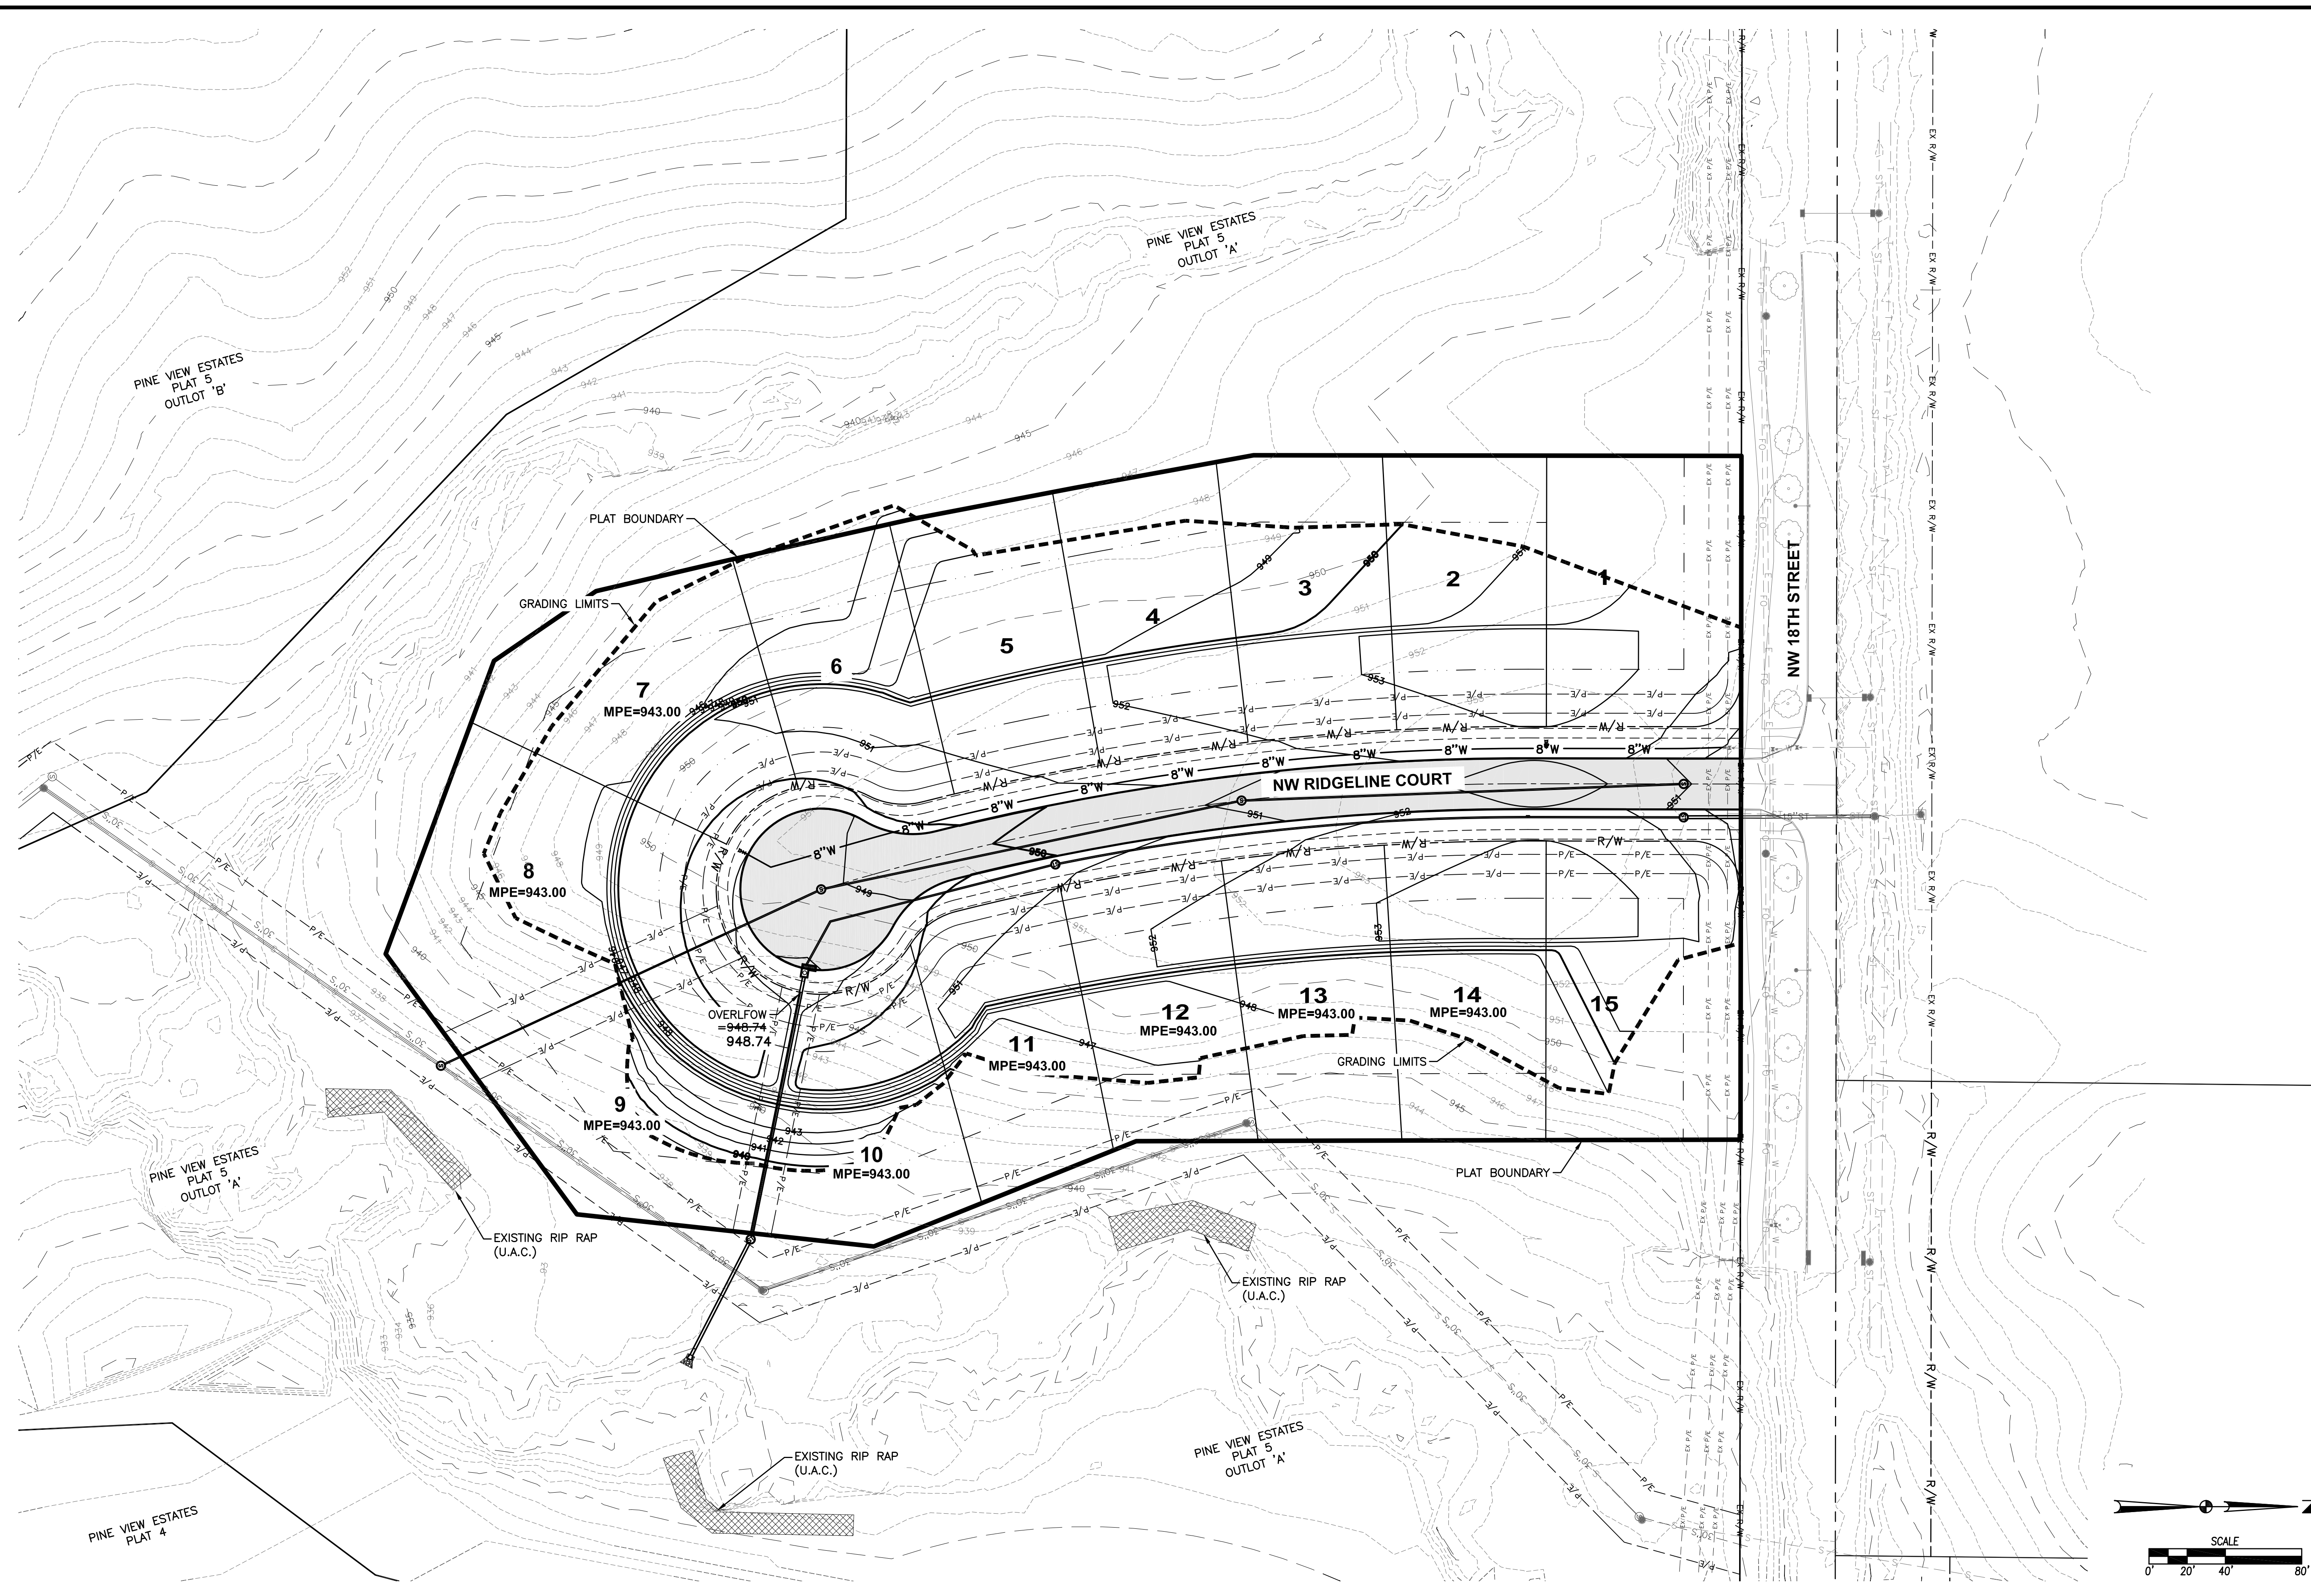

REVISIONS	DATE
AS-BUILTS SUBMITTAL	09/23/16
FINAL SUBMITTAL	06/14/16
SECOND SUBMITTAL	05/27/16
FIRST SUBMITTAL	04/29/16

3405 S.E. CROSSROADS DRIVE, SUITE G
 GRIMES, IOWA 50111
 PHONE: (515) 369-4400 FAX: (515) 369-4410
 ENGINEER: EKO EI: GH

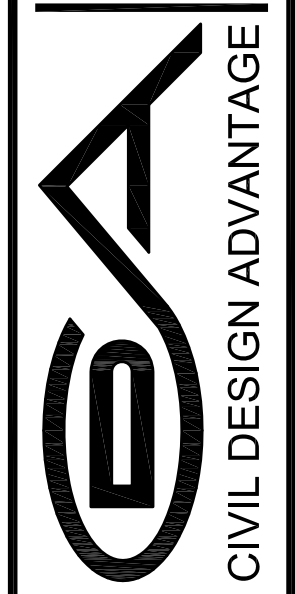

PINE VIEW ESTATES PLAT 6
GRADING PLAN