


WARNING:
 EXISTING ELECTRIC AND GAS IN THIS AREA.
 CONTRACTOR TO VERIFY LOCATION AND
 ELEVATION PRIOR TO CONSTRUCTION.
 ANY ADJUSTMENTS OR RELOCATIONS
 SHALL BE COORDINATED WITH THE
 CITY AND/OR UTILITY COMPANY
 AND SHALL BE CONSIDERED
 INCIDENTAL TO THE PROJECT.

NOTE
 REFER TO SEPARATE
 STORM WATER
 POLLUTION
 PREVENTION PLAN FOR
 DETAILS ON EROSION
 AND SEDIMENT
 CONTROLS.

AS-BUILT SUBMITTAL 07/09/12

REVISIONS	DATE
ADDED SANITARY EASEMENT	05/25/12
ADDED 5' ELECTRIC EASEMENTS	05/16/12
FINAL SUBMITTAL	09/19/11
FOURTH SUBMITTAL	09/16/11
THIRD SUBMITTAL	09/09/11
SECOND SUBMITTAL	08/26/11

3405 S.E. CROSSROADS DRIVE, SUITE G
 GRIMES, IOWA 50111
 PHONE: (515) 369-4400 FAX: (515) 369-4410

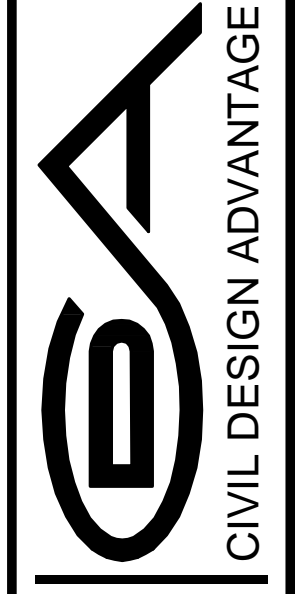

ANKENY, IOWA
 ENGINEER: EKO / ENH
 TECH:

ROCK CREEK CROSSING PLAT 1
GRADING PLAN